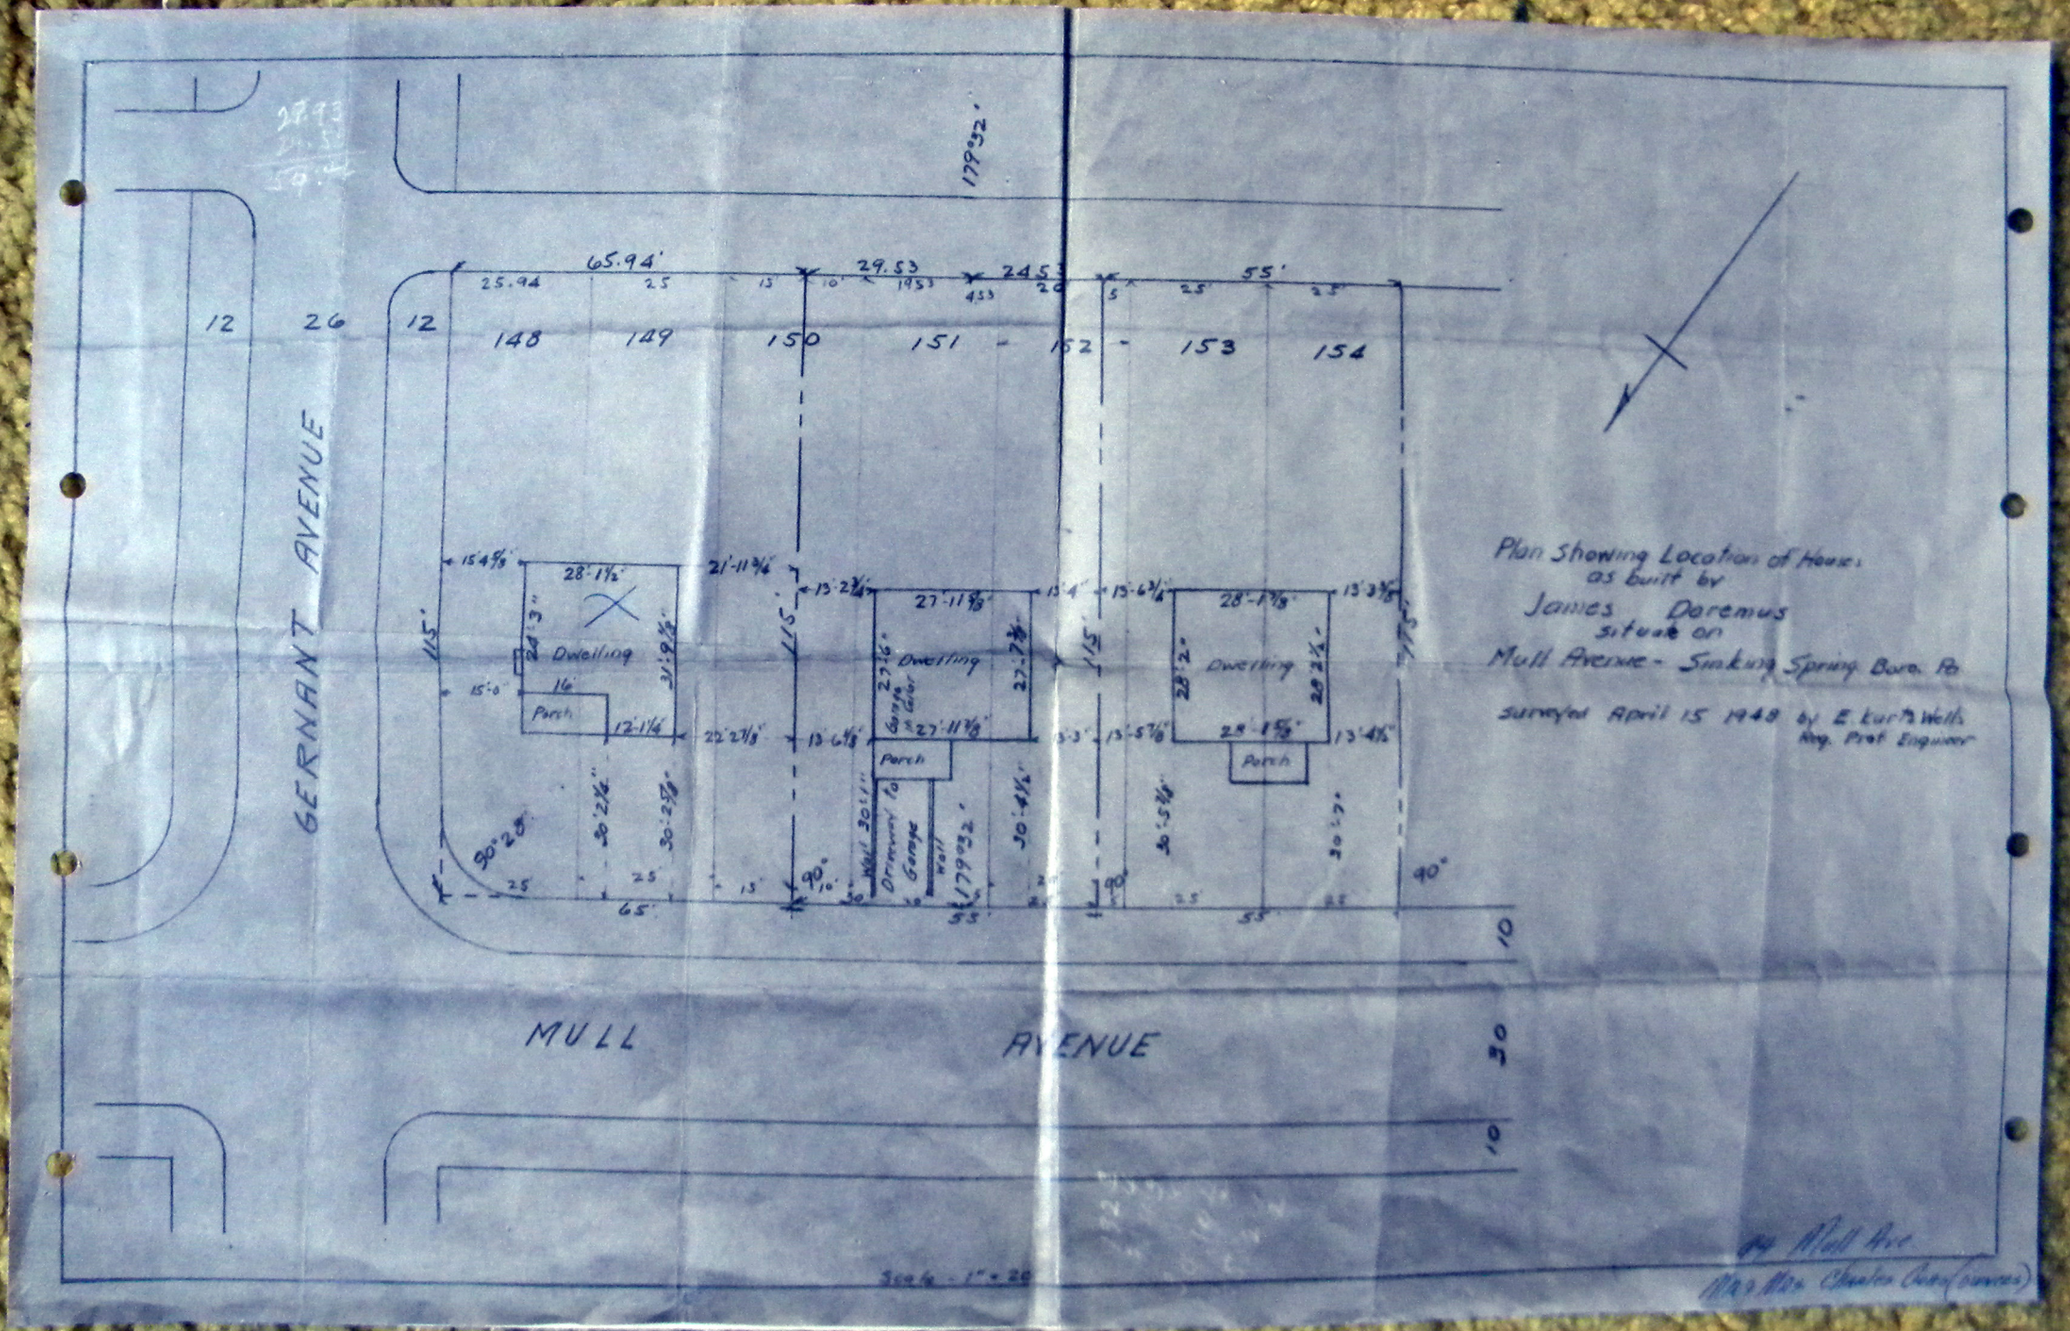
GERNANT AVENUE
MULL AVENUE
65.94'
29.53'
24.53'
55'
148
149
150
151
152
153
154
Dwelling
Porch
Garage
Plan Showing Location of Houses
as built by
James Doremus
situate on
Mull Avenue - Sinking Spring Boro. Pa
Surveyed April 15 1948 by E. Kurtz Wells
Reg. Prof. Engineer
Scale - 1" = 20'